BUILDING PERMIT AND
BOARD OF ADJUSTMENT
APPLICATION PLAN
FOR
MARY ELLEN VORCE
AND
EDWARD T. BOWSER
LOCUS
211 BRACKETT ROAD
RYE, NH
SCALE: 1"=20' MAY 14, 2012

TAX MAP 19 LOT 98

PREPARED BY STOCKTON SERVICES
PO BOX 1306 HAMPTON, NH 03843-1306
(603) 929-7404

20 0 10 20 40 80

GRAPHIC SCALE 1 INCH = 20 FEET

STATE OF NEW HAMPSHIRE
LICENSED LAND SURVEYOR
NO. 752
ANNE W. BIALOBRZESKI
SIGNATURE
05/14/12

NOTES

1. OWNERS OF RECORD:
   MARY ELLEN VORCE AND EDWARD T. BOWSER
   211 BRACKETT ROAD, RYE, NH 03870
   LOT AREA: 29,700 SF± (0.68 ACRE±)
   DEED REFERENCE: RCRD 2940-2076
   TAX MAP 19 LOT 98
   ZONE: SINGLE RESIDENTIAL
2. NO PORTION OF SUBJECT PROPERTY IS LOCATED WITHIN A FEDERALLY DESIGNATED FLODD HAZARD ZONE. REFERENCE FEMA FLOOD INSURANCE RATE MAP NUMBER 33015C0286E EFFECTIVE DATE MAY 17, 2005
3. UTILITY LOCATIONS ARE BASED ON BEST AVAILABLE INFORMATION ONLY AND MUST BE FIELD VERIFIED BY APPLICABLE PROVIDERS PRIOR TO CONSTRUCTION.
   EXISTING FORCE MAIN TO BE RELOCATED AS NEEDED AND SLEEVED UNDER DRIVEWAY AS SPECIFIED ON APPROVED SEPTIC DESIGN PLAN (NHDES CA2010102642A)

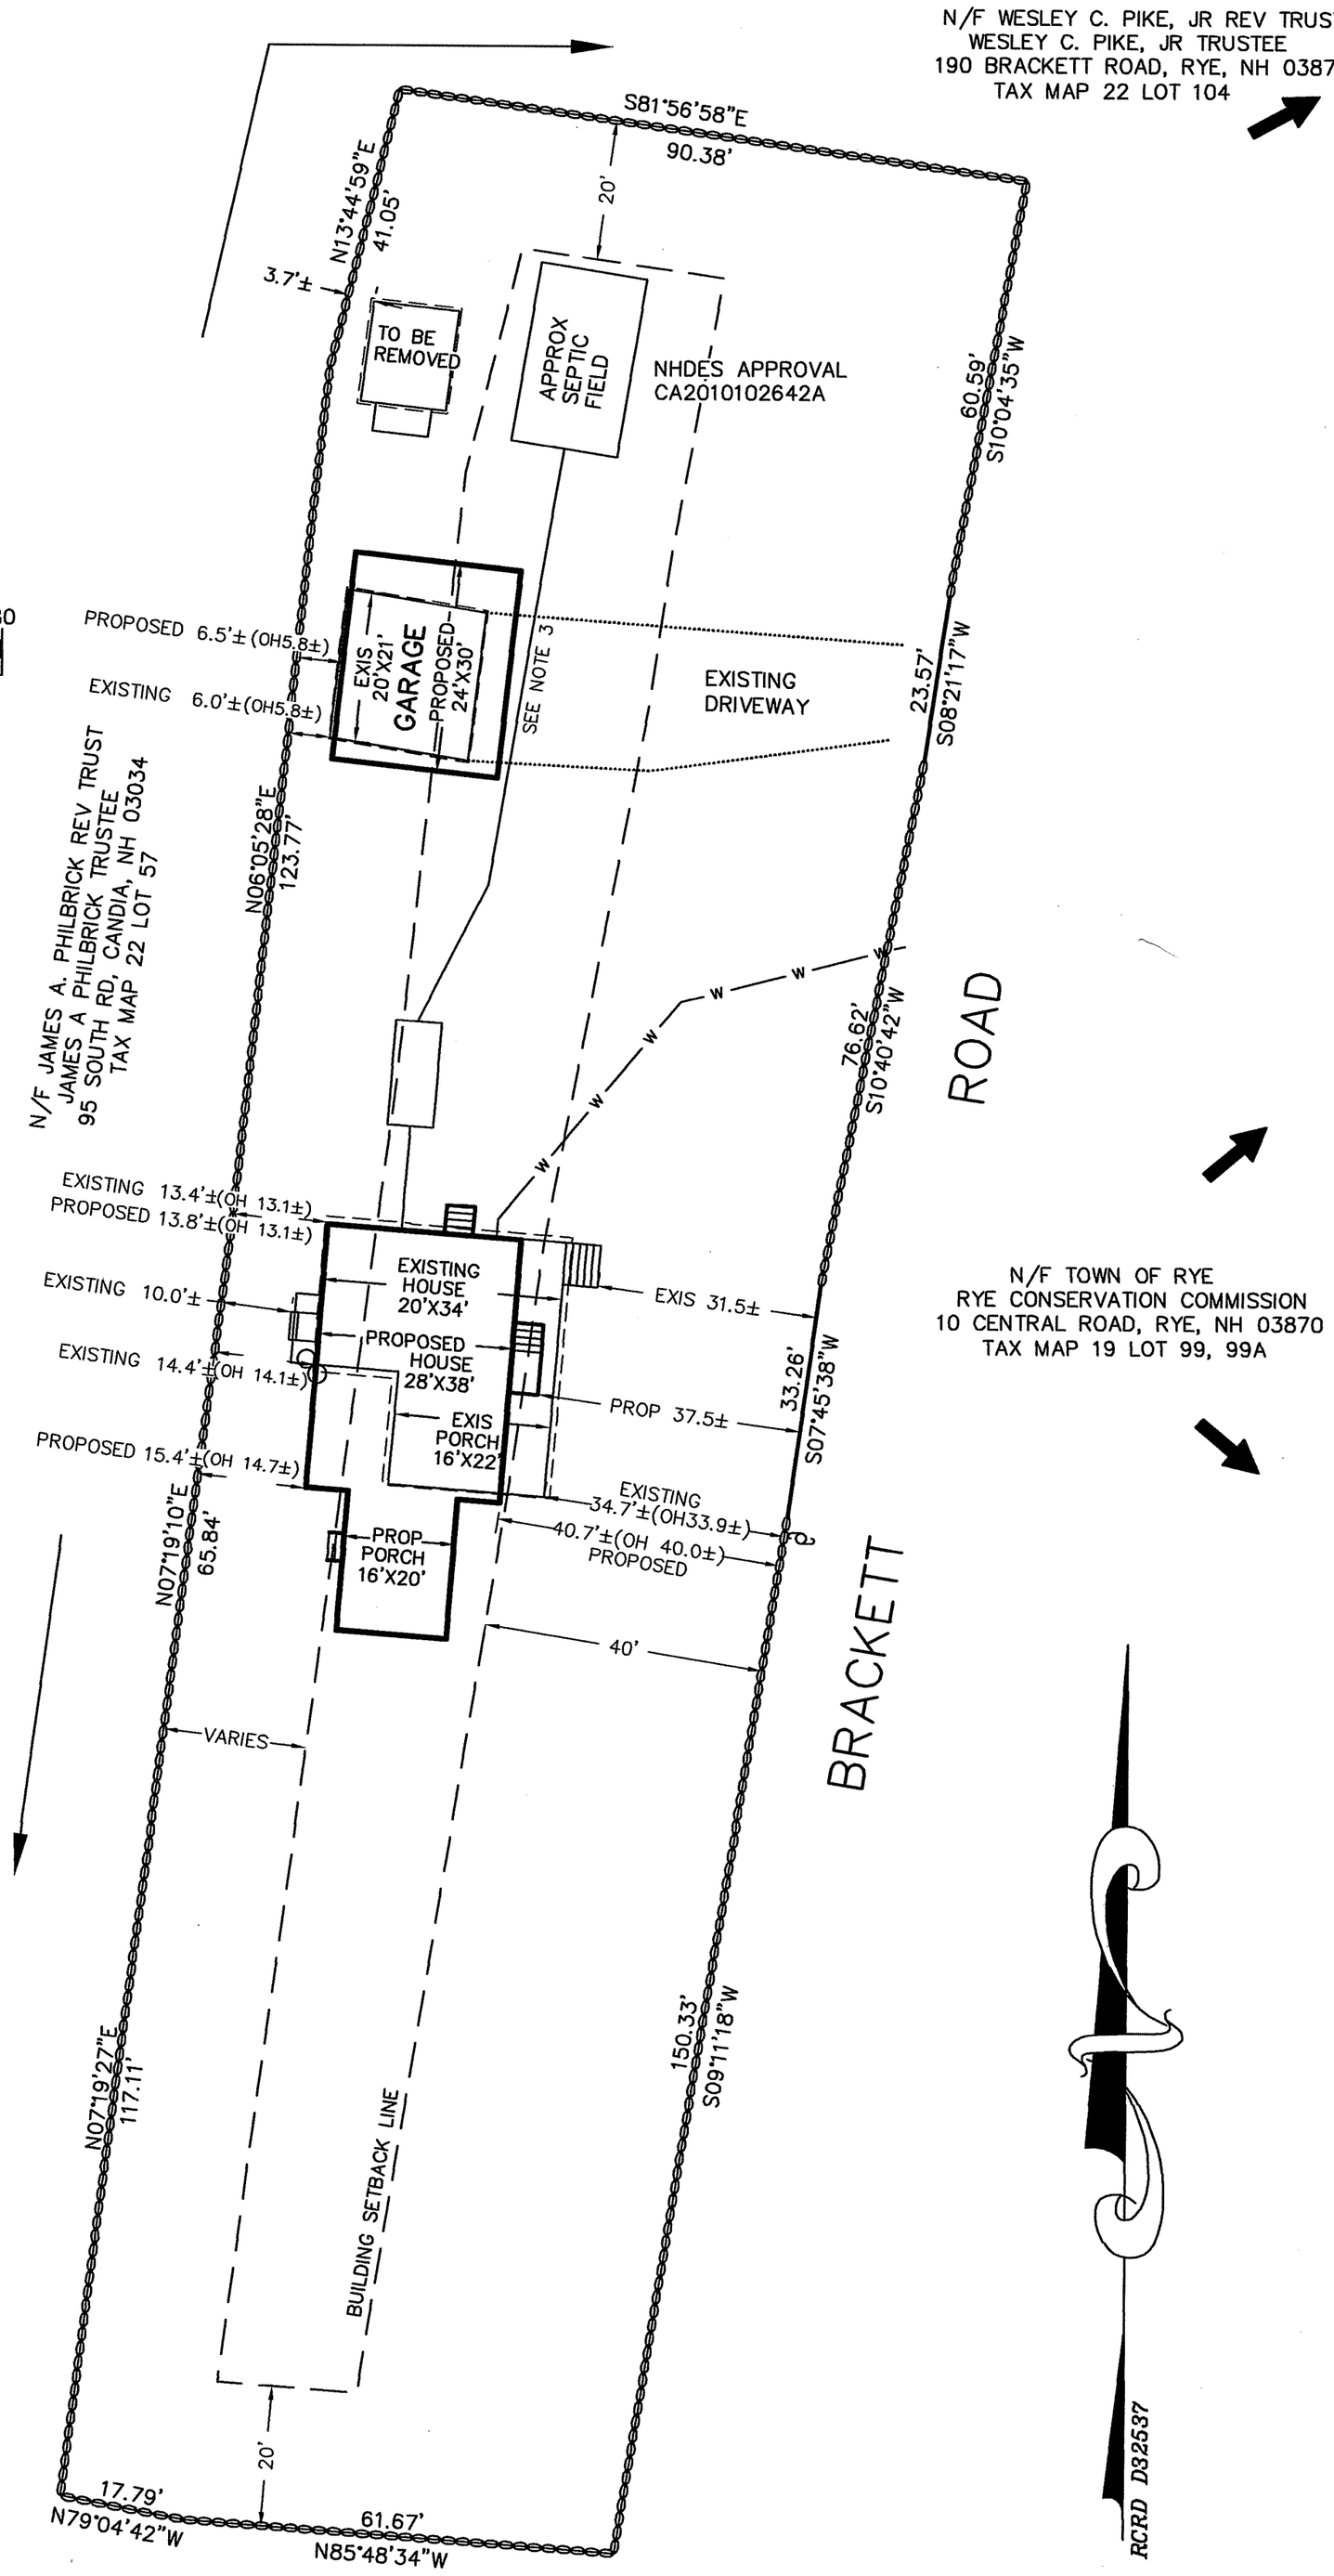

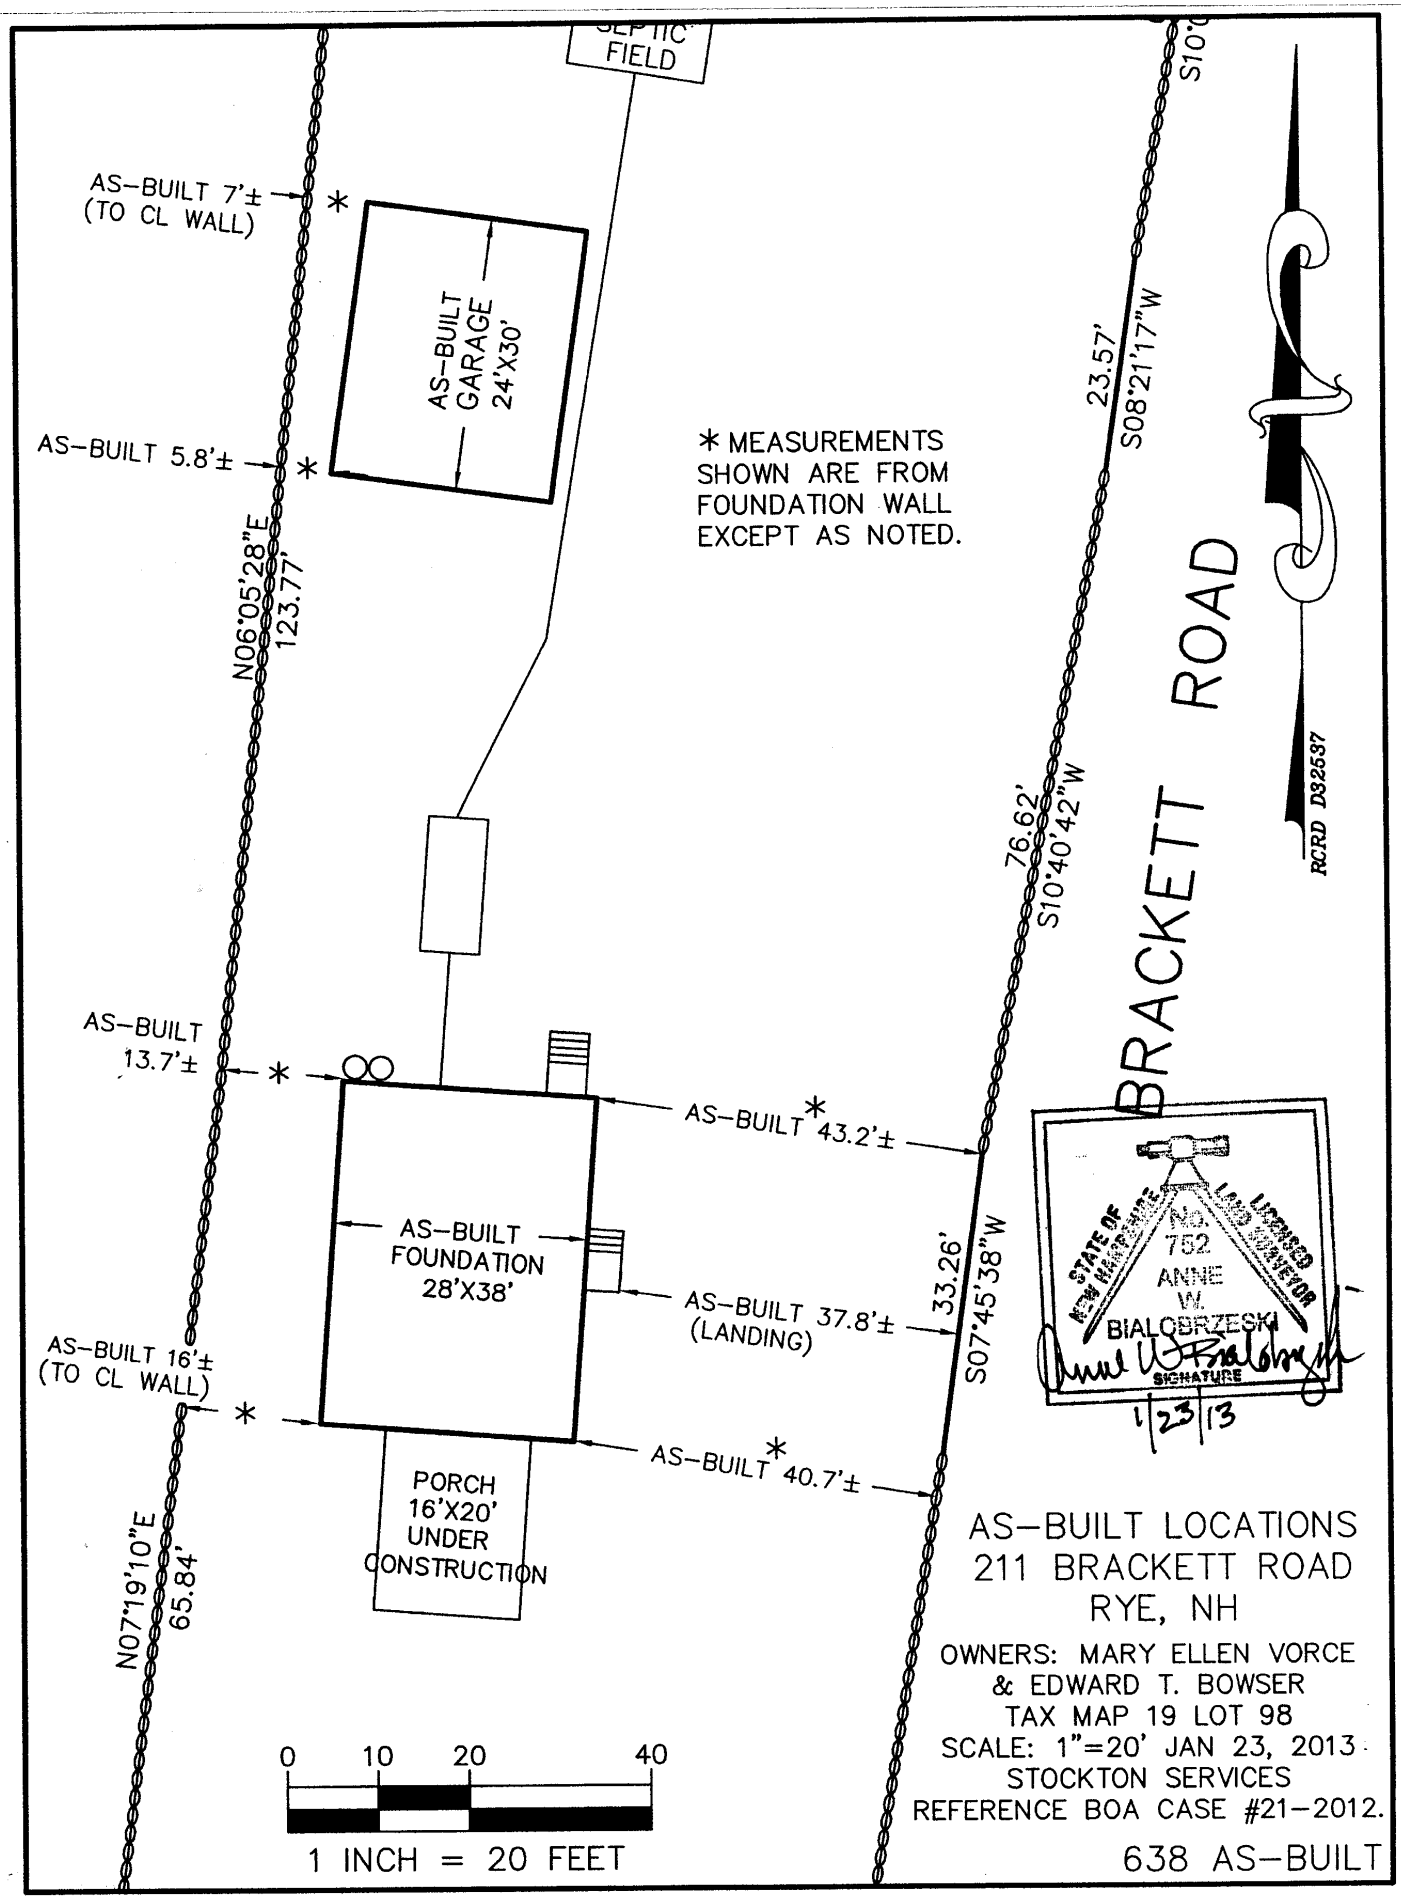

AS-BUILT LOCATIONS
211 BRACKETT ROAD
RYE, NH

OWNERS: MARY ELLEN VORCE & EDWARD T. BOWSER
TAX MAP 19 LOT 98
SCALE: 1"=20' JAN 23, 2013
STOCKTON SERVICES
REFERENCE BOA CASE #21-2012.

638 AS-BUILT